



FILED
 Condominium Book 8 Page 85
 Date 8-25-05 Time 4:12 AM
 WILLIE L. COMINGTON
 REGISTER OF DEEDS
 DURHAM COUNTY, NC


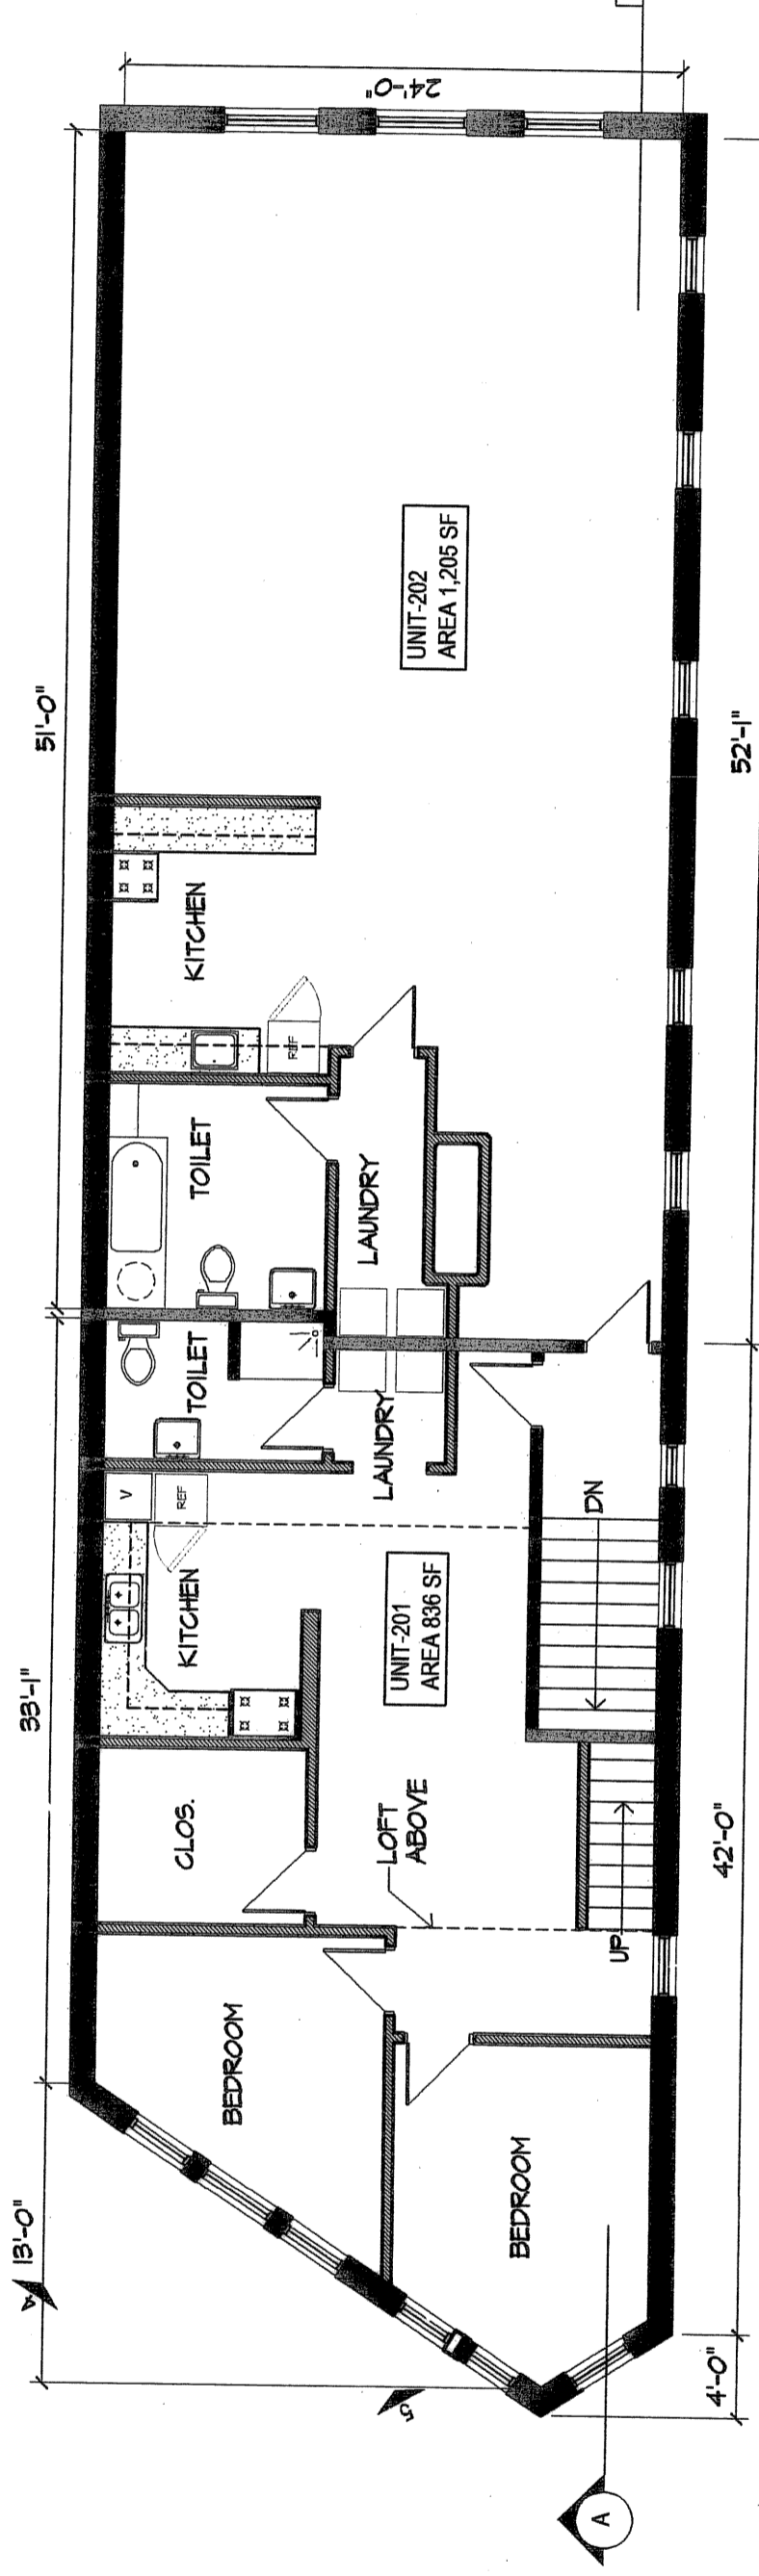


2 SECOND FLOOR PLAN
 SCALE: 1/8"=1'-0"

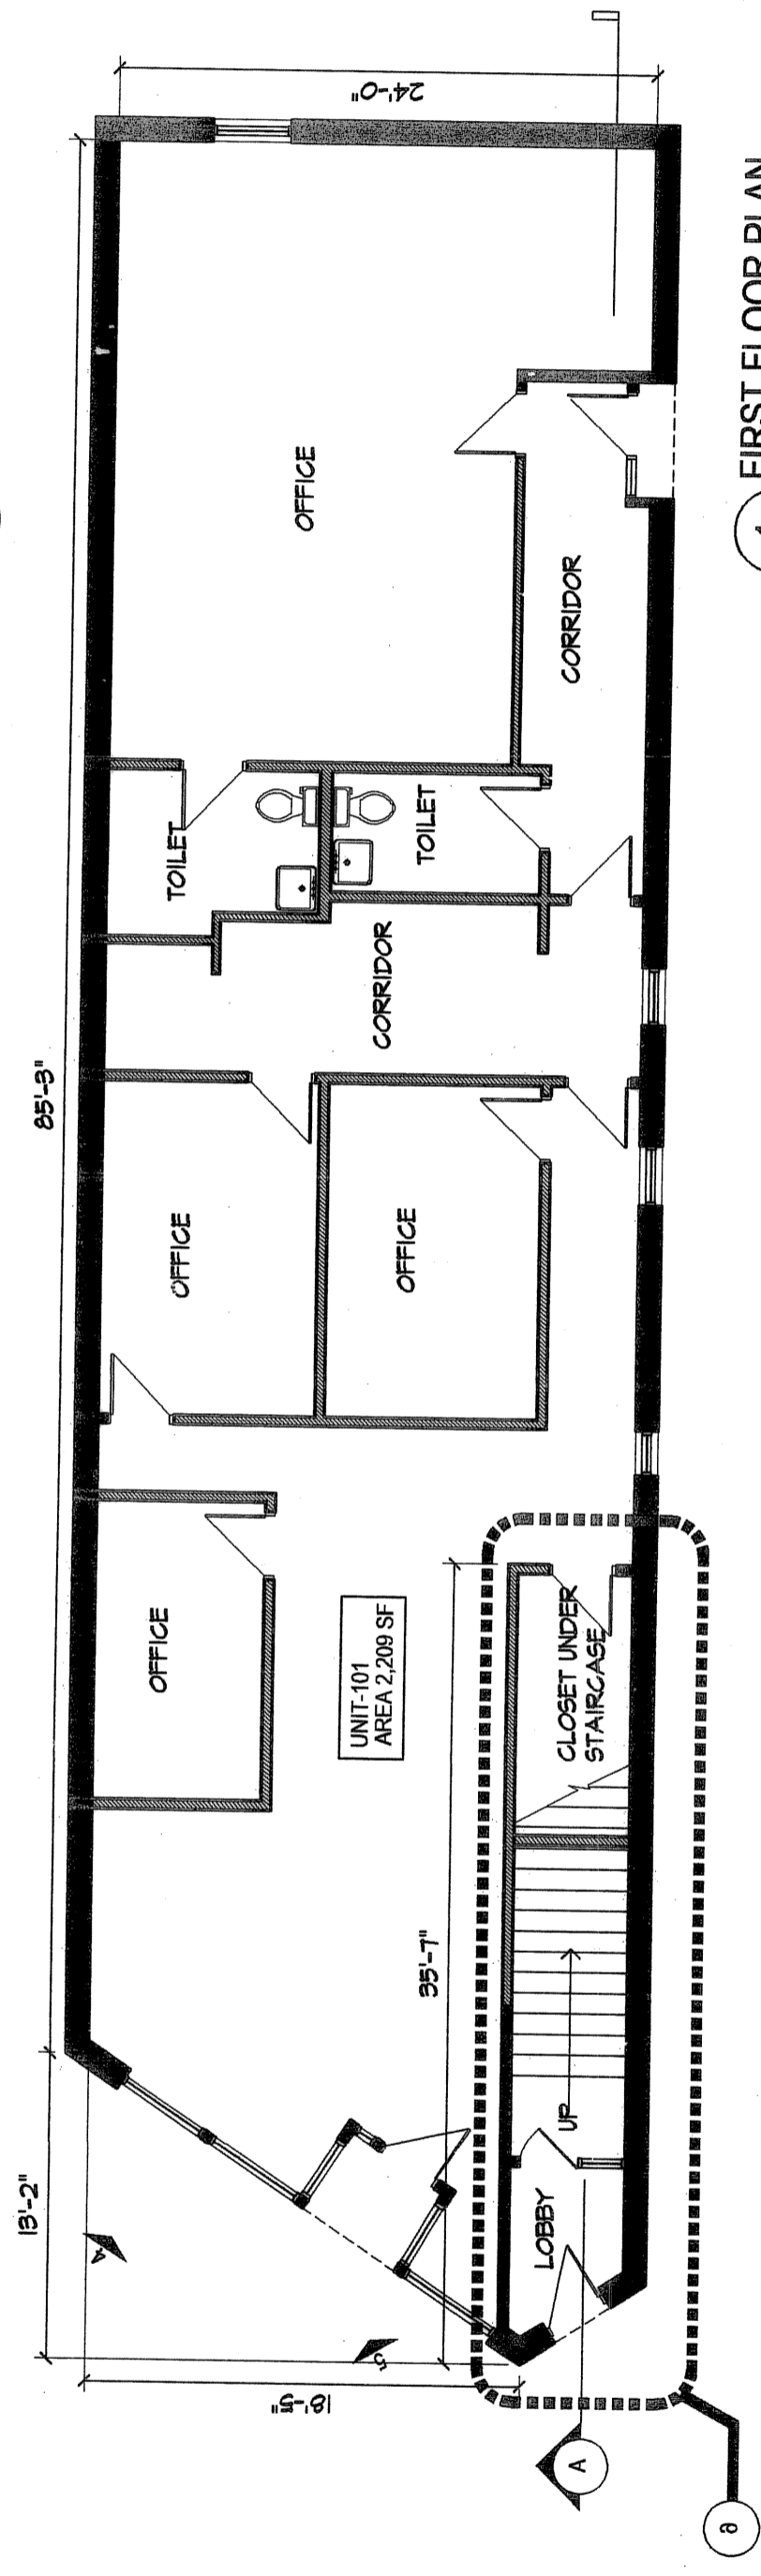

1 FIRST FLOOR PLAN
 SCALE: 1/8"=1'-0"

THIS IS TO CERTIFY THAT THESE PLANS FULLY & ACCURATELY DEPICT THE LAYOUT, LOCATION, CEILING & FLOOR ELEVATION, UNIT NUMBERS AND DIMENSIONS OF THE UNITS AS BUILT.

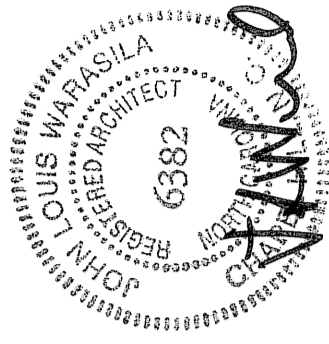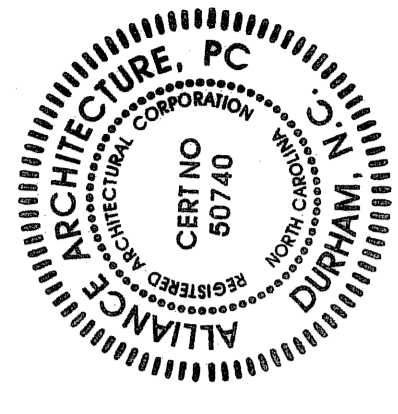


104 West Parrish Street Condominium

104 West Parrish St.

PLANS

Scale: 1/8" = 1'-0"
 Date: August 19, 2005

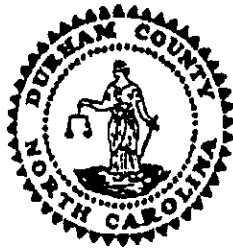

Willie L. Covington
Register of Deeds
Durham County, North Carolina

CONDO




FOR REGISTRATION REGISTER OF DEEDS
Willie L. Covington
DURHAM COUNTY, NC
2005 AUG 25 04:12:19 PM
BK:8 PG:85-87 FEE:\$21.00

INSTRUMENT # 2005039881

GRANTOR(S) Antonette C. Mason
OWNER(S): 104 West Parish Street Condominium

3 of 4

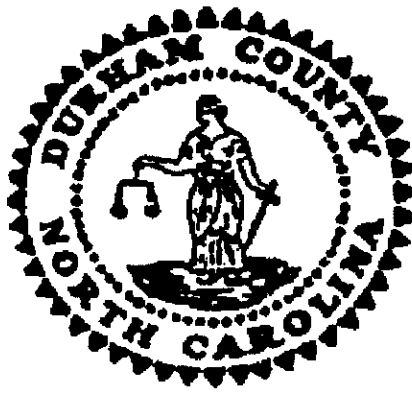

WILLIE L. COVINGTON
REGISTER OF DEEDS, DURHAM COUNTY
DURHAM COUNTY COURTHOUSE
200 E. MAIN STREET
DURHAM, NC 27701


PLEASE RETAIN YELLOW TRAILER PAGE

It is part of recorded document, and must be submitted with original for re-recording
and/or cancellation.

Filed For Registration: 08/25/2005 04:12:19 PM
Book: CONDO 8 Page: 85-87
Document No.: 2005039881
CONDO 3 PGS \$21.00
Recorder: APRIL J WILLIAMS

State of North Carolina, County of Durham

WILLIE L. COVINGTON , REGISTER OF DEEDS

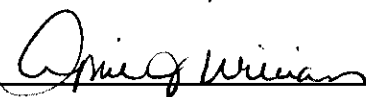By: 
Deputy/~~Assistant~~ Register of Deeds



2005039881