
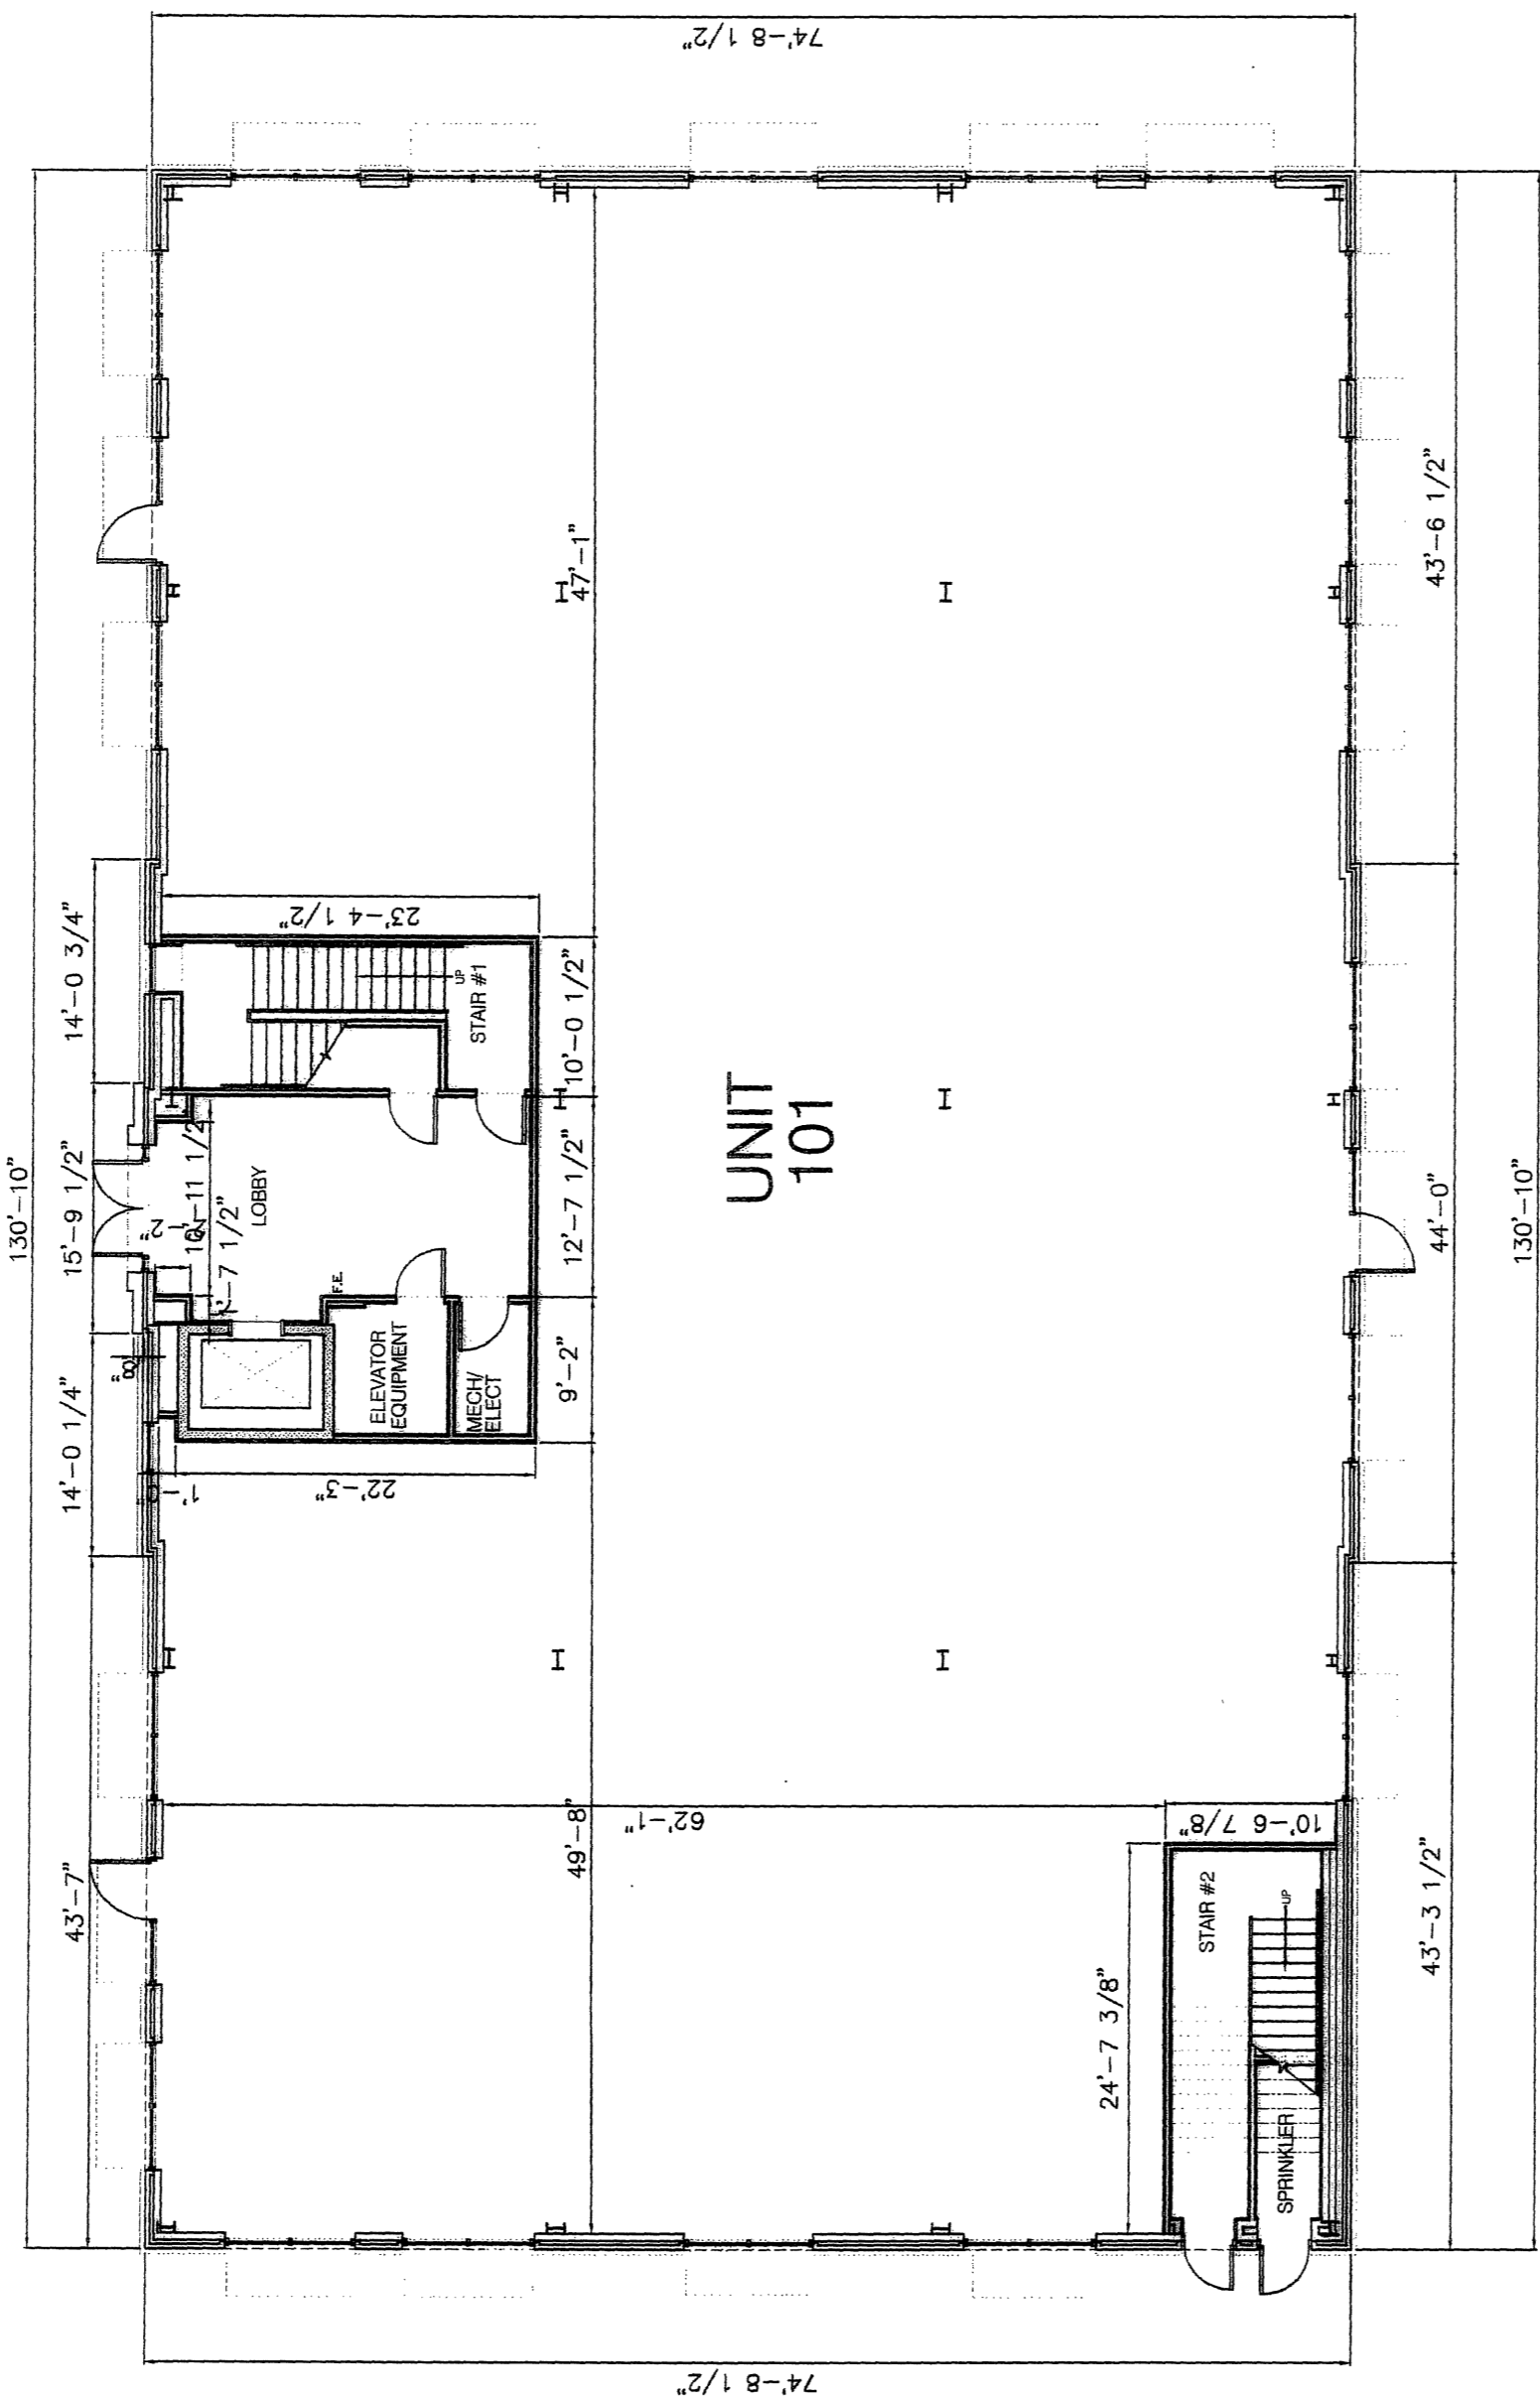
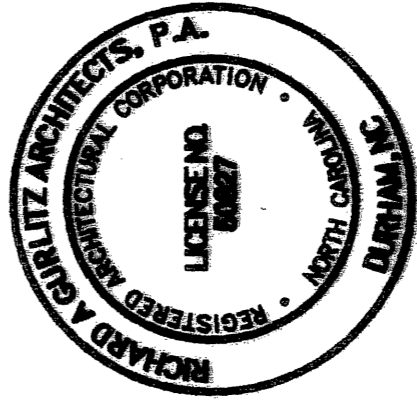


I, THE UNDERSIGNED ARCHITECT, BEING LICENSED UNDER THE PROVISION OF CHAPTER 89A OF THE GENERAL STATUTE HEREBY CERTIFY THAT THIS DRAWING IS ACCURATE AND COMPLIES WITH LOCAL BUILDING CODES AND CONTAINS ALL THE INFORMATION REQUIRED BY NORTH CAROLINA GENERAL STATUTE SECTION 47C-2-108, THE LAYOUT, LOCATION, CEILING, AND FLOOR ELEVATIONS, UNIT NUMBERS, AND DIMENSIONS OF THE UNITS AS BUILT, AND THE SAME HAVE BEEN SUBSTANTIALLY COMPLETED. UNITS WHERE CONSTRUCTION IS NOT COMPLETED ARE SO INDICATED, AND FINAL DIMENSIONS WILL BE FIELD VERIFIED UPON COMPLETION.

*[Handwritten Signature]*  
SIGNATURE

SEE DECLARATION OF CONDOMINIUM RECORDED ON OCTOBER 21, 2008 IN BOOK 4153 PAGE 713 DURHAM COUNTY REGISTRY, AS AMENDED. THE UNITS ARE SUBJECT TO SUBVISION OR RELOCATION OF BOUNDARIES IN ACCORDANCE WITH SAID DECLARATION AND THESE FLOOR PLANS MAY BE AMENDED ACCORDINGLY.

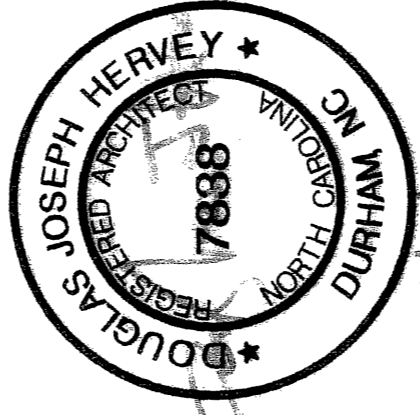

First Floor Plan

FILED  
Condominium Book 9 Page 99  
Date 4-4-07 Time 10:40 AM  
WILLIE L. COWINGTON  
REGISTER OF DEEDS  
DURHAM COUNTY, NC

First Floor Plan  
KITT CREEK BUILDING  
Durham, NC  
03/30/07



Willie L. Covington  
Register of Deeds  
Durham County, North Carolina

CONDO



2007014712


FOR REGISTRATION REGISTER OF DEEDS  
Willie L. Covington  
DURHAM COUNTY, NC  
2007 APR 04 10:40:15 AM  
BK:9 PG:99-101 FEE:\$21.00

INSTRUMENT # 2007014712

GRANTOR(S)  
OWNER(S):

Kitt Creek Building

4 of 4

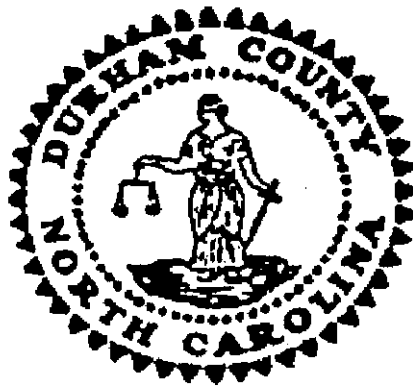

WILLIE L. COVINGTON  
REGISTER OF DEEDS, DURHAM COUNTY  
DURHAM COUNTY COURTHOUSE  
200 E. MAIN STREET  
DURHAM, NC 27701

**PLEASE RETAIN YELLOW TRAILER PAGE**

It is part of recorded document, and must be submitted with original for re-recording  
and/or cancellation.

\*\*\*\*\*

Filed For Registration: 04/04/2007 10:40:15 AM  
Book: CONDO 9 Page: 99-101  
Document No.: 2007014712  
CONDO 3 PGS \$21.00  
Recorder: SHARON M CEARNEL



2007014712